



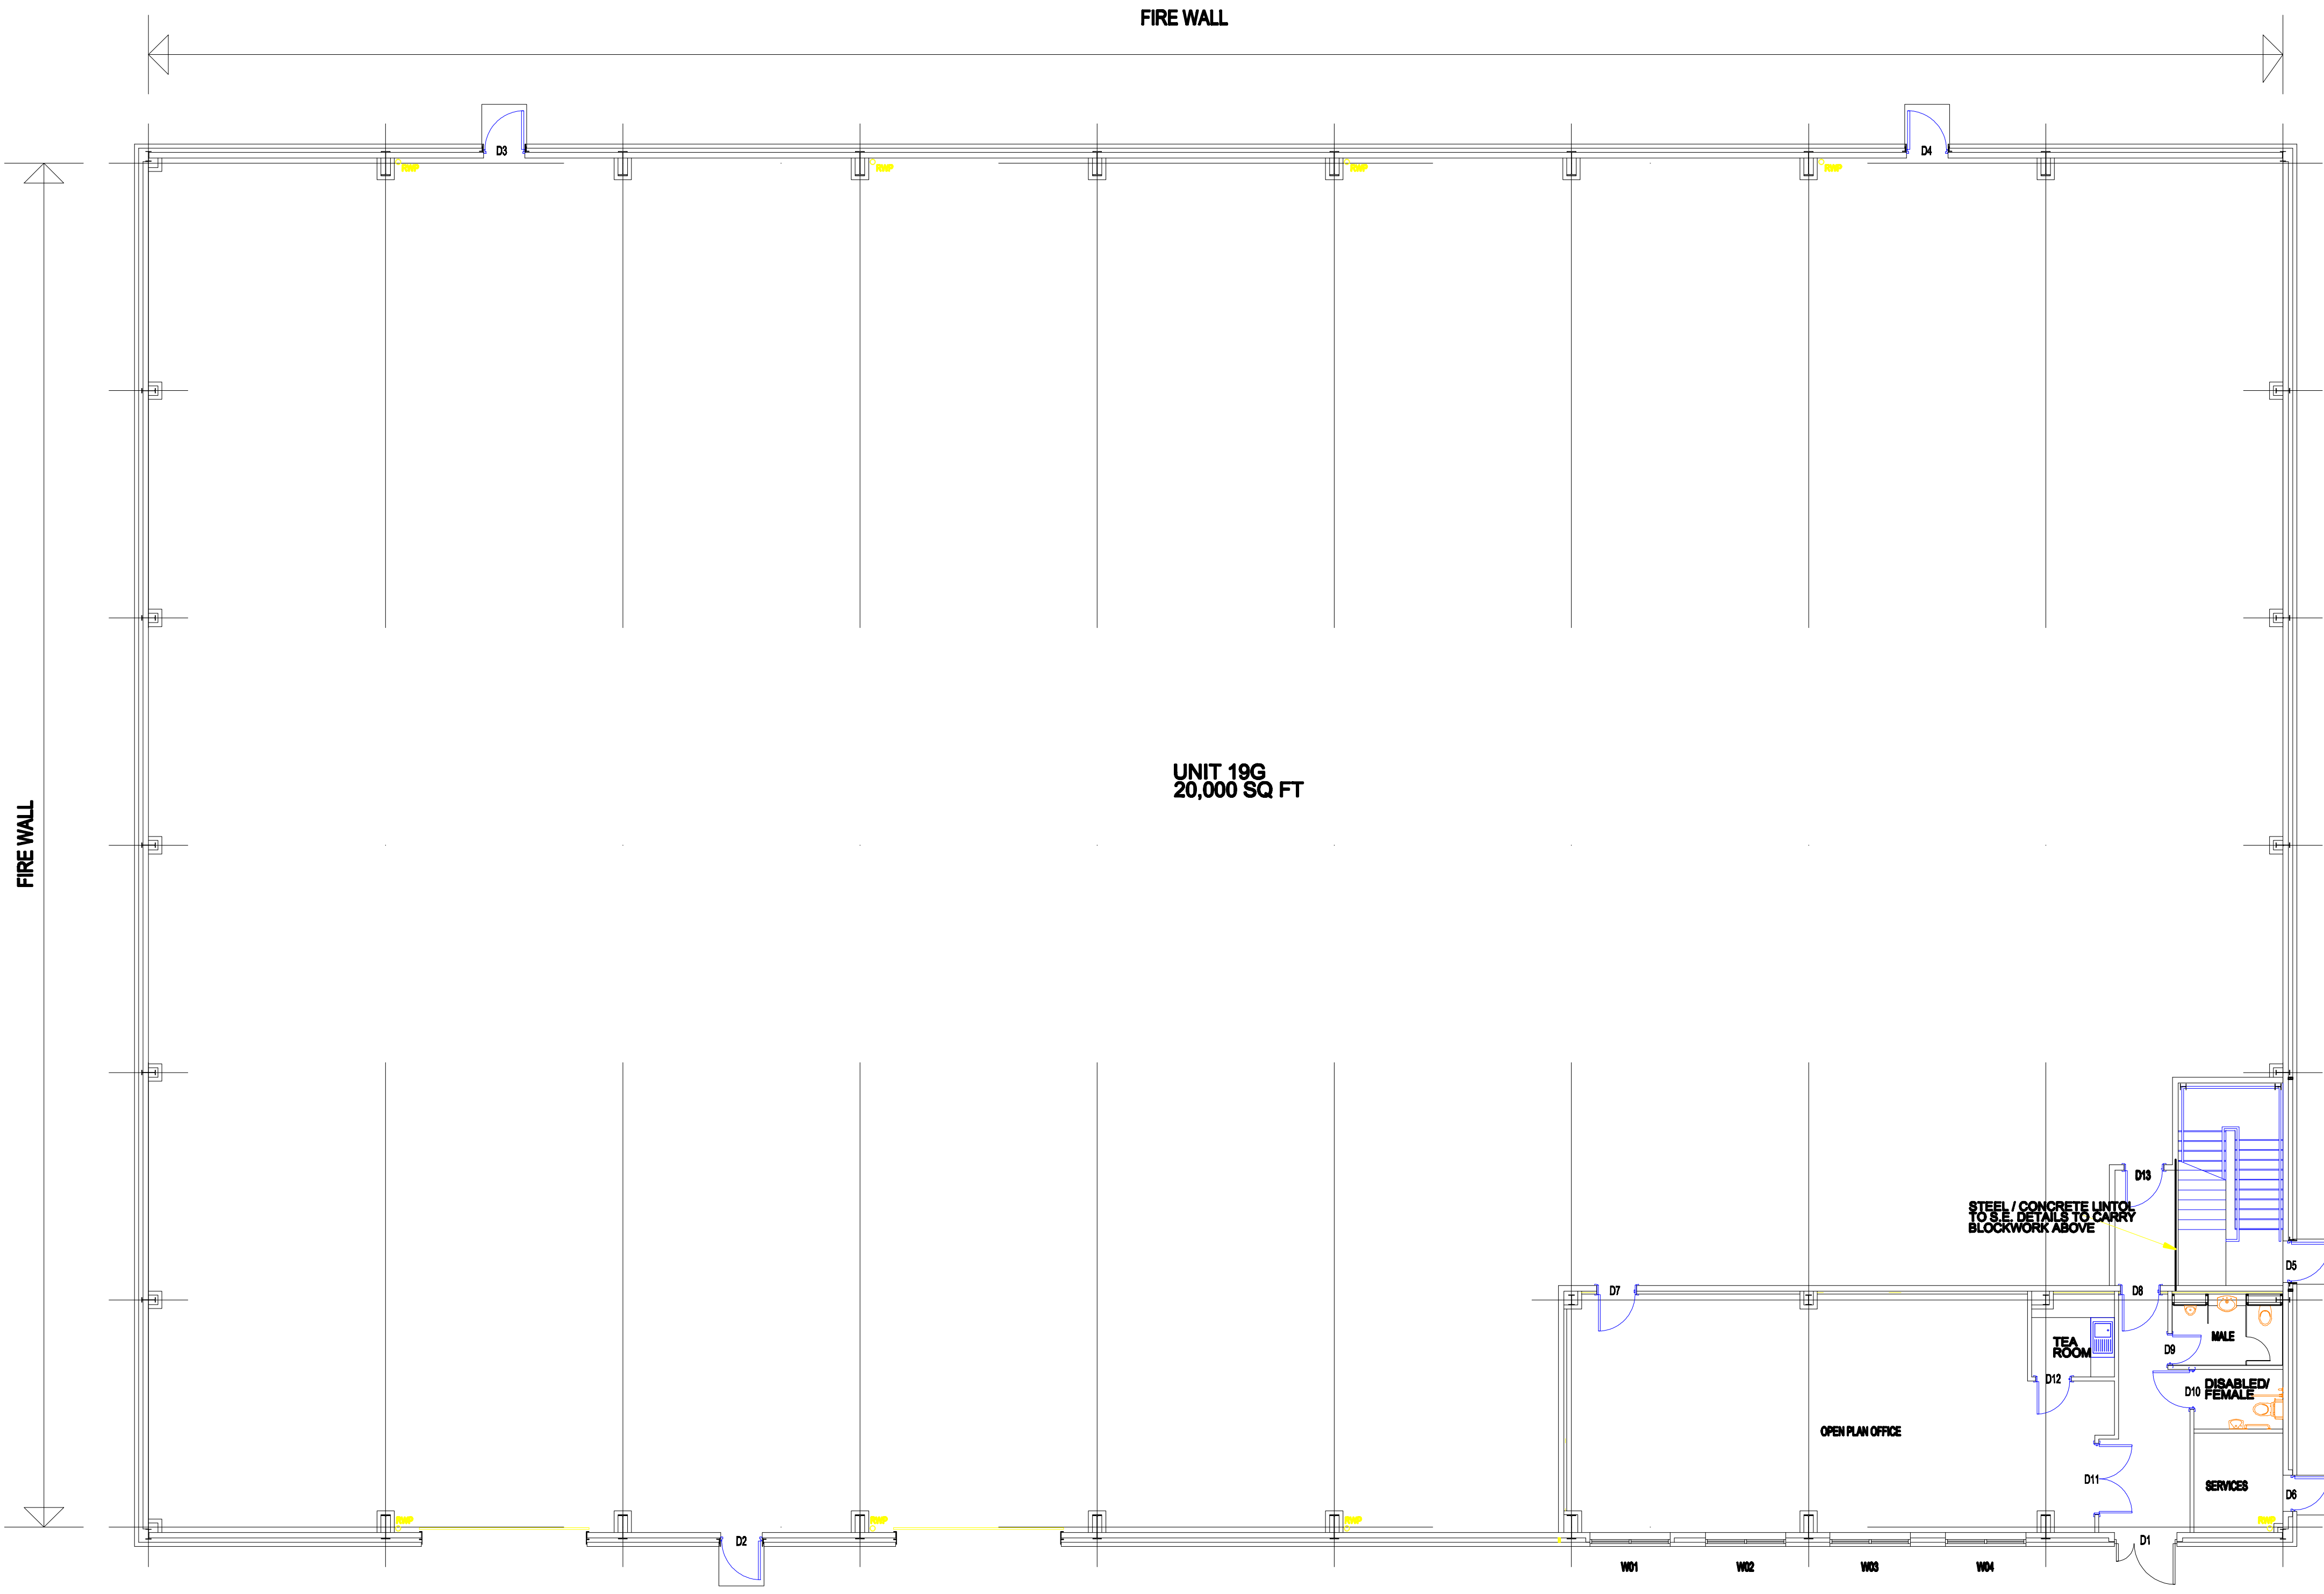

GROUND FLOOR

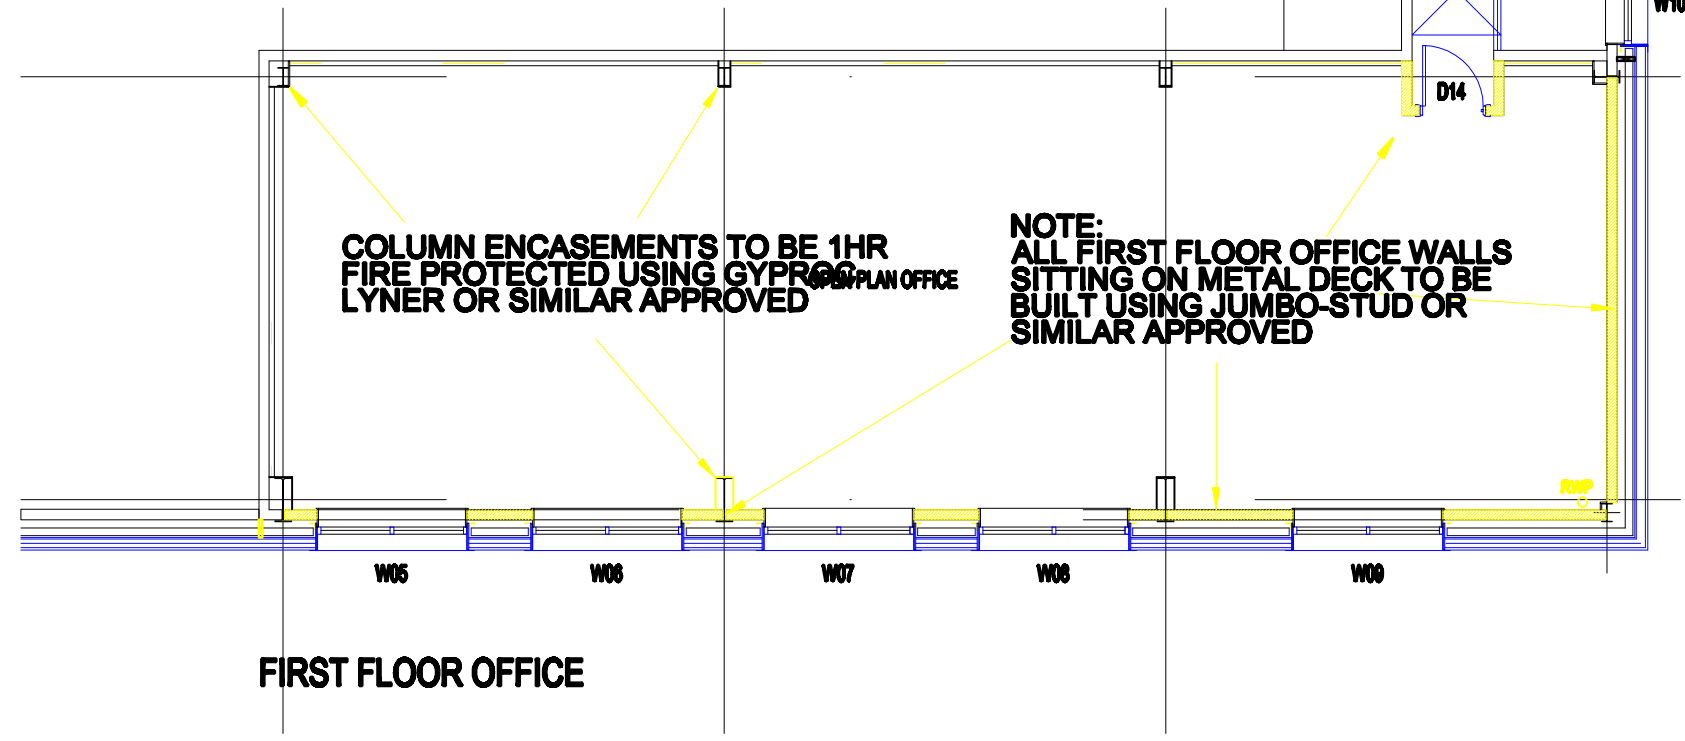

FIRST FLOOR OFFICE

FIRE WALL

UNIT 19G
20,000 SQ FT

FOR EXACT SETOUT OF RAIN WATER PIPE LOCATIONS,
PLEASE REFER TO WHL GUTTER DRAWINGS

Notes

Copyright
The copyright in this document is the property of KPP Architects.
It is not to be reproduced, stored in a retrieval system, or
transmitted in any form or by any means, electronic, mechanical,
photocopying, recording, or by any information storage and
retrieval system, without the prior written consent of KPP Architects.
Any unauthorised use of this document is strictly prohibited.

KPP
ARCHITECTS
KILMARTIN PLOWMAN
& PARTNERS LIMITED

Project and Building Consultancy		
G	JH	22.08.07 AS - BUILT
F	JH	20.05.07 OFFICE FLOOR
E	JH	21.03.07 OFFICE FLOOR
D	JH	06.01.07 OFFICE FLOOR
C	JH	28.01.07 OFFICE FLOOR
B	JH	18.01.07 OFFICE FLOOR
A	JH	04.01.07 OFFICE FLOOR
REV	DATE	DESCRIPTION
1	04.01.07	UNIT 19G 223 5700
2	04.01.07	UNIT 19G 223 5700
KPP
ARCHITECTS
KILMARTIN PLOWMAN
& PARTNERS LIMITED

LODGE HOUSE 12 TOWN STREET
HORSFORTH LEEDS LS18 4RJ

T: 0113 228 0400 F: 0113 228 0475
E: enquiries@kpp-leeds.co.uk
W: www.kpp-leeds.co.uk

PHASE 11
FOLLINGSBY PARK
GATEHEAD
UNIT 19G BUILDING PLAN

AS - BUILT
1276-14
301
G

AS - BUILT